

South Carolina Department of Health and Environmental Control  
Office of Ocean and Coastal Resource Management  
104 Parker Drive  
Beaufort, South Carolina 29906

**March 13, 2014**  
**Permit Amendment Public Notice**  
***Steven & Michelle Karol, OCRM-11-815-L***

The Department has received an application for a permit for the alteration of a critical area. The application was submitted pursuant to the Coastal Zone Management Act (Act 123) of 1977 South Carolina General Assembly. The application in brief, is described as follows:

**LOCATION:** On and adjacent to Colleton River at 158 Spring Island Drive, Okatie, Beaufort County, South Carolina.  
TMS: R600-024-000-0005-0000.

**WORK:** The permittee has requested an amendment to the issued permit. Specifically, the permittee seeks to increase the walkway length from 275' to 300' and add an 8' x 14' floating boatlift landward of the existing floating dock. The amendment is for modifications to a private, recreational dock.

This public notice is being distributed to all known interested persons and agencies to assist in developing facts on which a decision by the Department can be based. Comments concerning the proposed work must be submitted in writing, setting forth sufficient detail to furnish a clear understanding of the reasons for support or opposition.

Comments regarding this application must be received by the Department on or before **March 23, 2014**. For more information, please contact:  
**Paul Wojoski** at 843-846-9400 or via email at [wojoskpa@dhec.sc.gov](mailto:wojoskpa@dhec.sc.gov).


**NOTE:** Plans depicting the proposed work are available and will be provided upon receipt of a written request or may be viewed on the Department website at [www.scdhec.gov/environment/ocrm/public\\_notice.htm](http://www.scdhec.gov/environment/ocrm/public_notice.htm).



**GASQUE & ASSOCIATES INC.**  
**LAND SURVEYORS & PLANNERS**

28 PROFESSIONAL VILLAGE CIRCLE, BEAUFORT, S.C.  
P.O. BOX 1363, BEAUFORT, S.C.  
PHONE (843) 522-1798

DAVID A. DODD & KATHLEEN W  
R600 024 000 0022 0000  
156 SPRING ISLAND DR  
OKATIE S.C. 29909

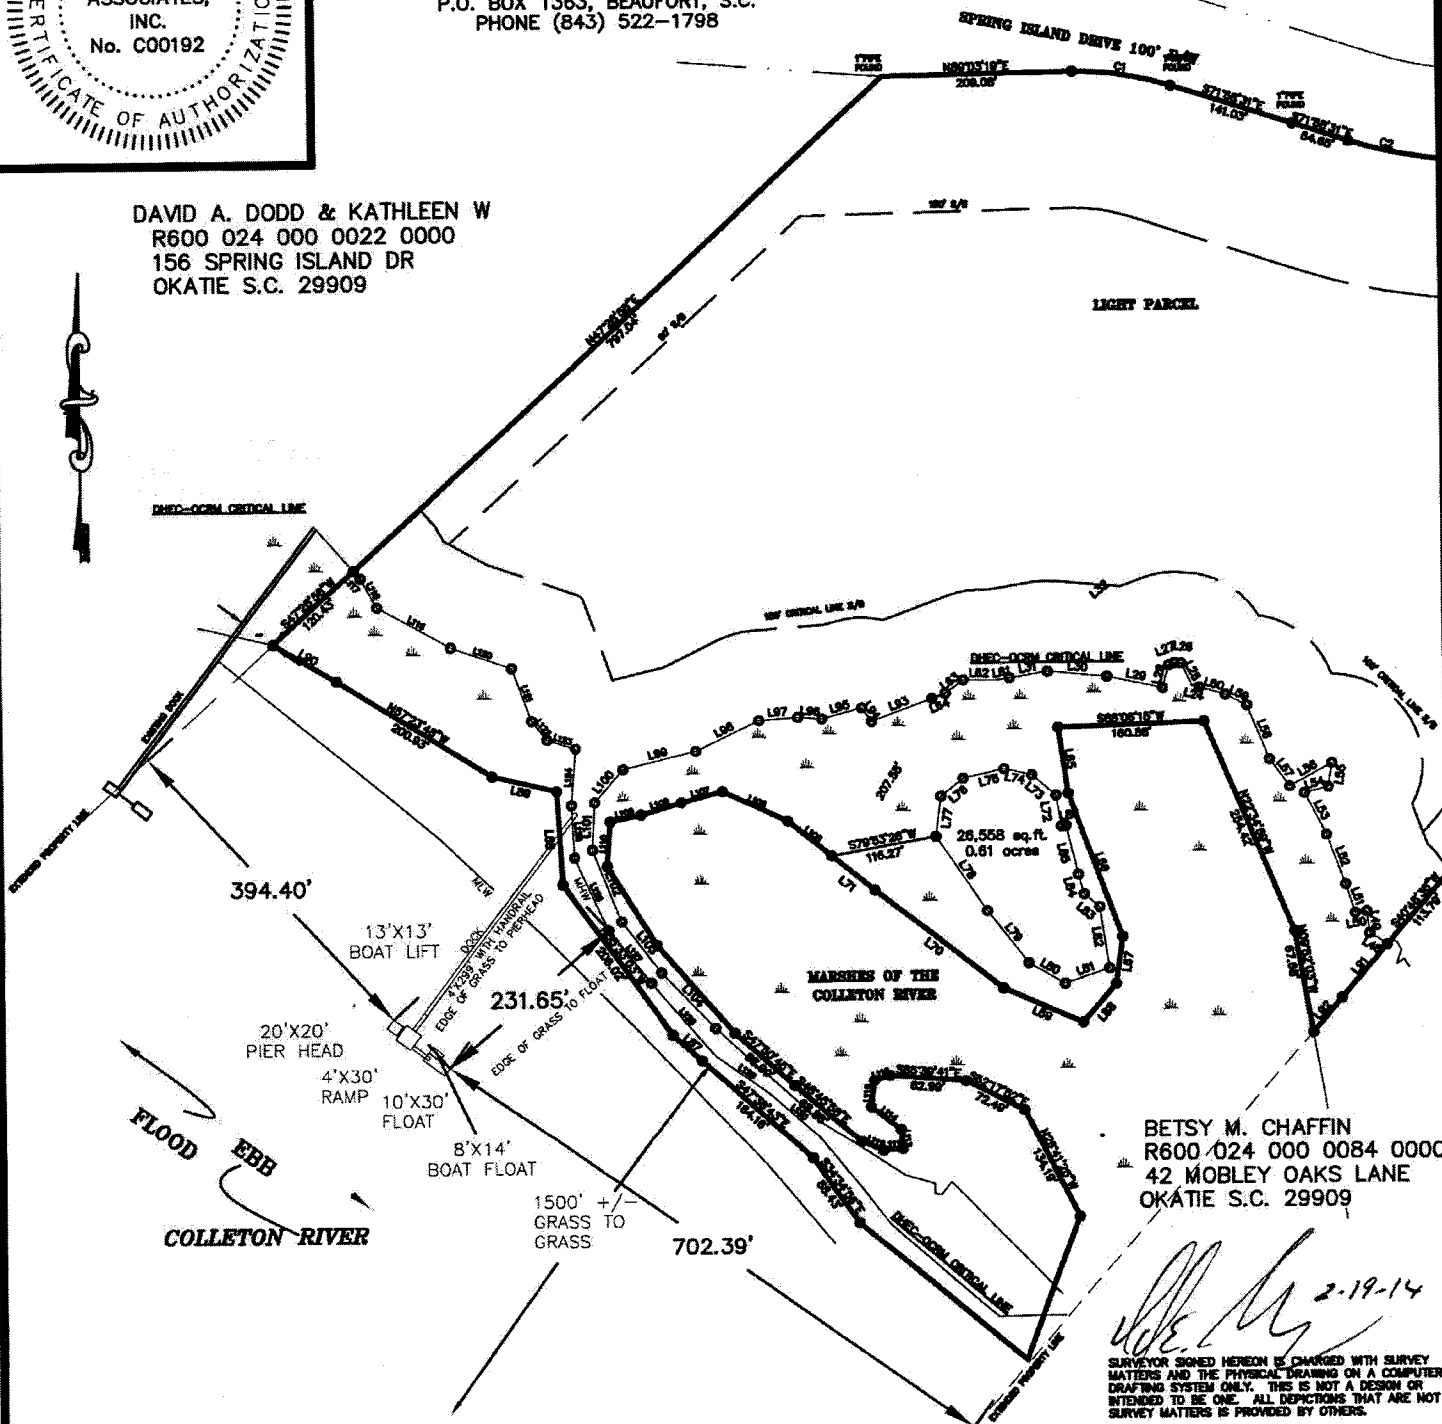

BETSY M. CHAFFIN  
R600 024 000 0084 0000  
42 MOBLEY OAKS LANE  
OKATIE S.C. 29909

*[Signature]* 2-19-14  
SURVEYOR SIGNED HEREON IS CHARGED WITH SURVEY MATTERS AND THE PHYSICAL DRAWING ON A COMPUTER DRAFTING SYSTEM ONLY. THIS IS NOT A DESIGN OR INTENDED TO BE ONE. ALL DEPICTIONS THAT ARE NOT SURVEY MATTERS IS PROVIDED BY OTHERS.

**ADJACENT PROPERTY OWNERS:**

1. DAVID A. DODD & KATHLEEN W  
R600 024 000 0022 0000  
156 SPRING ISLAND DR  
OKATIE S.C. 29909
2. BETSY M. CHAFFIN  
R600 024 000 0084 0000  
42 MOBLEY OAKS LANE  
OKATIE S.C. 29909

**OCRM-11-815-L**  
**amendment**

R600 024 000 0005 0000  
STEVEN KAROL & MICHELLE KAROL  
158 SPRING ISLAND DR  
OKATIE S.C. 29909

**DOCK ASBUILT SURVEY**

IN: COLLETON RIVER  
AT: SPRING ISLAND

COUNTY OF: BEAUFORT  
STATE: SOUTH CAROLINA

JOB# 41336 DSGN 7

DATE: 2/17/2014